
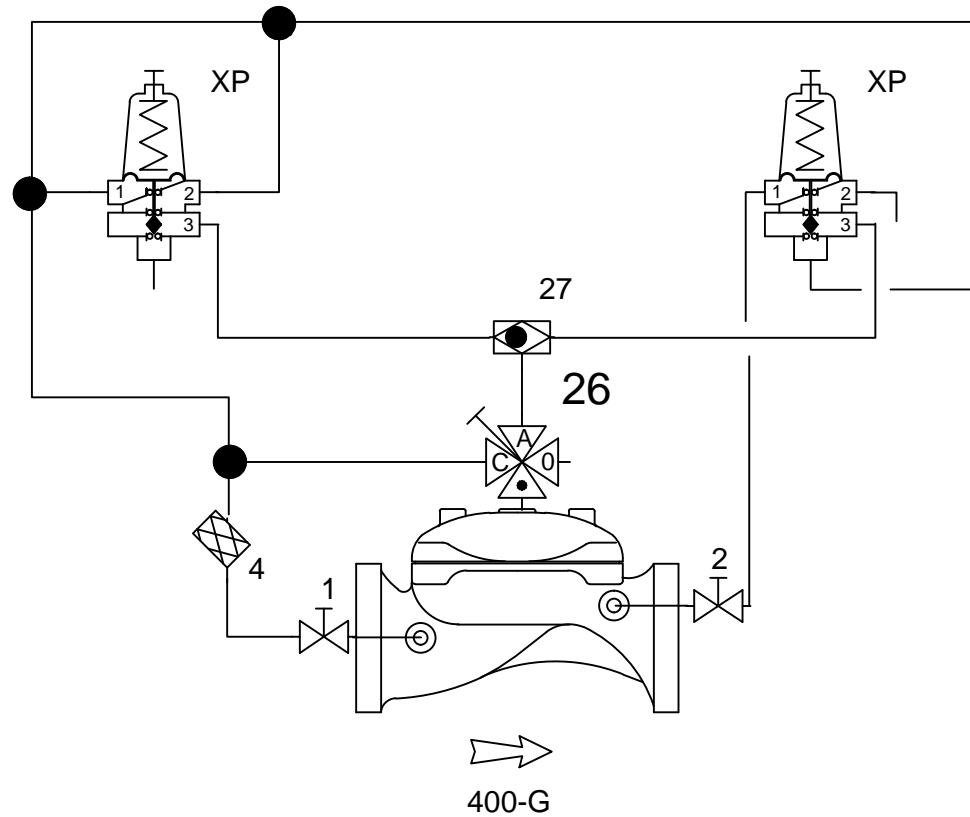


Components	
#1 & 2	1/4" ball valves
#4	Inlet brass strainer
#27	Brass shuttle valve
#XP	Brass PCX three way pilot
#26	Brass SAGIV
400-G	50-100mm 400 series
Fittings	Brass
Tubing	HP nylon

Suitable for 50 , 80 & 100mm valve sizes

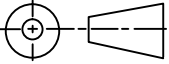

<p>Not to Scale</p> 	<p><b>Bermad Water Technologies</b>          7 Inglewood Drive , Thomastown , Vic 3074          Ph (03) 9464 5949 Fax (03) 9464 2382</p>	<p>Drawn by :          Date :</p>
<p>Email Address          colin@bermad.com.au</p>	<p>Project : <b>Bermad sustaining and reducing valve with three way brass pilots 423 BXW</b></p>	<p>Drawing Number :</p>
<p>Revision Number / Date</p>		